
No.	Date	Reference	CHG LTR	Sign
②	SEP28'88	EFF CHG	BS-1	Ogata
①	AUG02'86	Misdescript	BJ-1	Ogata

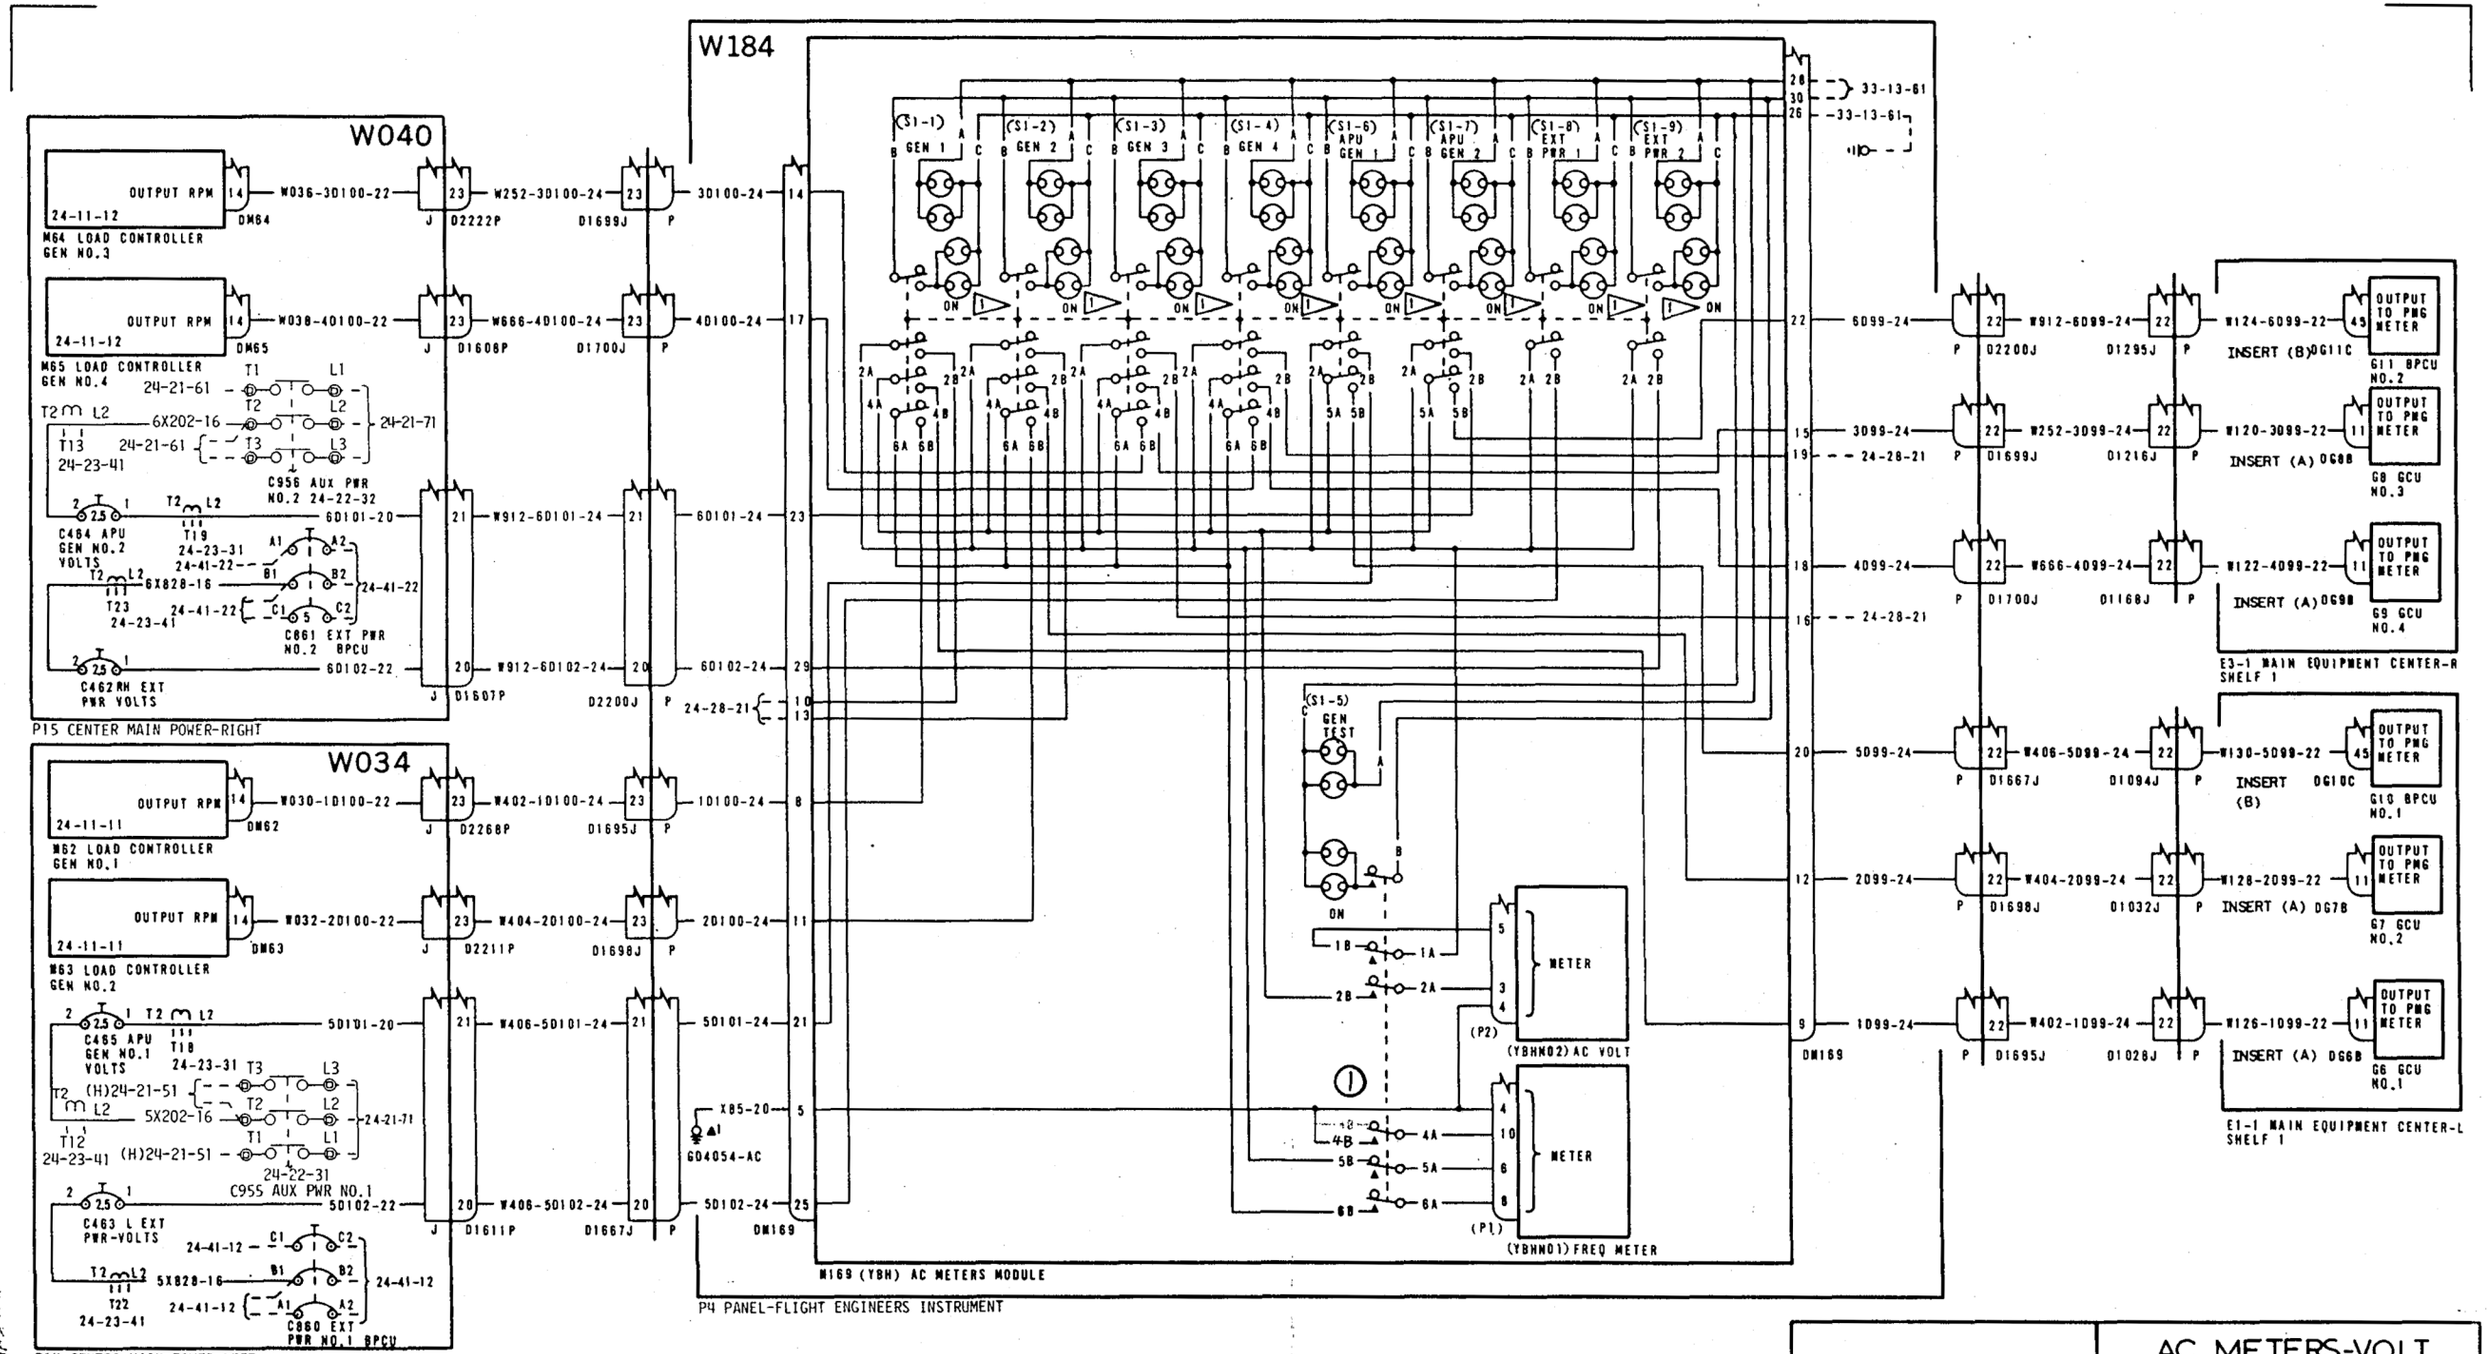

NOTES:

▽ SWITCHES S1-1 THRU S1-9, WITH THE EXCEPTION OF S1-5 ARE MECHANICALLY INTERLOCKED SO ONLY ONE SWITCH CAN BE DEPRESSED AT THE SAME TIME BS-1

DRAFTED BY
CHECKED BY

DRAWING NO. 61B74707
PAGE DATE: ~~MAY 12'86~~ JUN 06/88
DCN: ~~BJ-1~~
CHANGE:

AC METERS-VOLT AND FREQUENCY

149-150, 154-155, 161-163, 166, 169-170, 173 176-179, 212-213, 183-187, 189 ②

RD221-RD229
RS251-RS270
RS001-RS010

24-28-11
PAGE 3